



Legend

- EXISTING GROUND CONTOUR
- PROJECT BOUNDARY
- PROPOSED PROPERTY LINE
- ADJUTING PROPERTY LINE
- BUILDING SETBACK
- PROPOSED BUILDING AREA
- PROPOSED BUILDING/CUTTING ENVELOPE

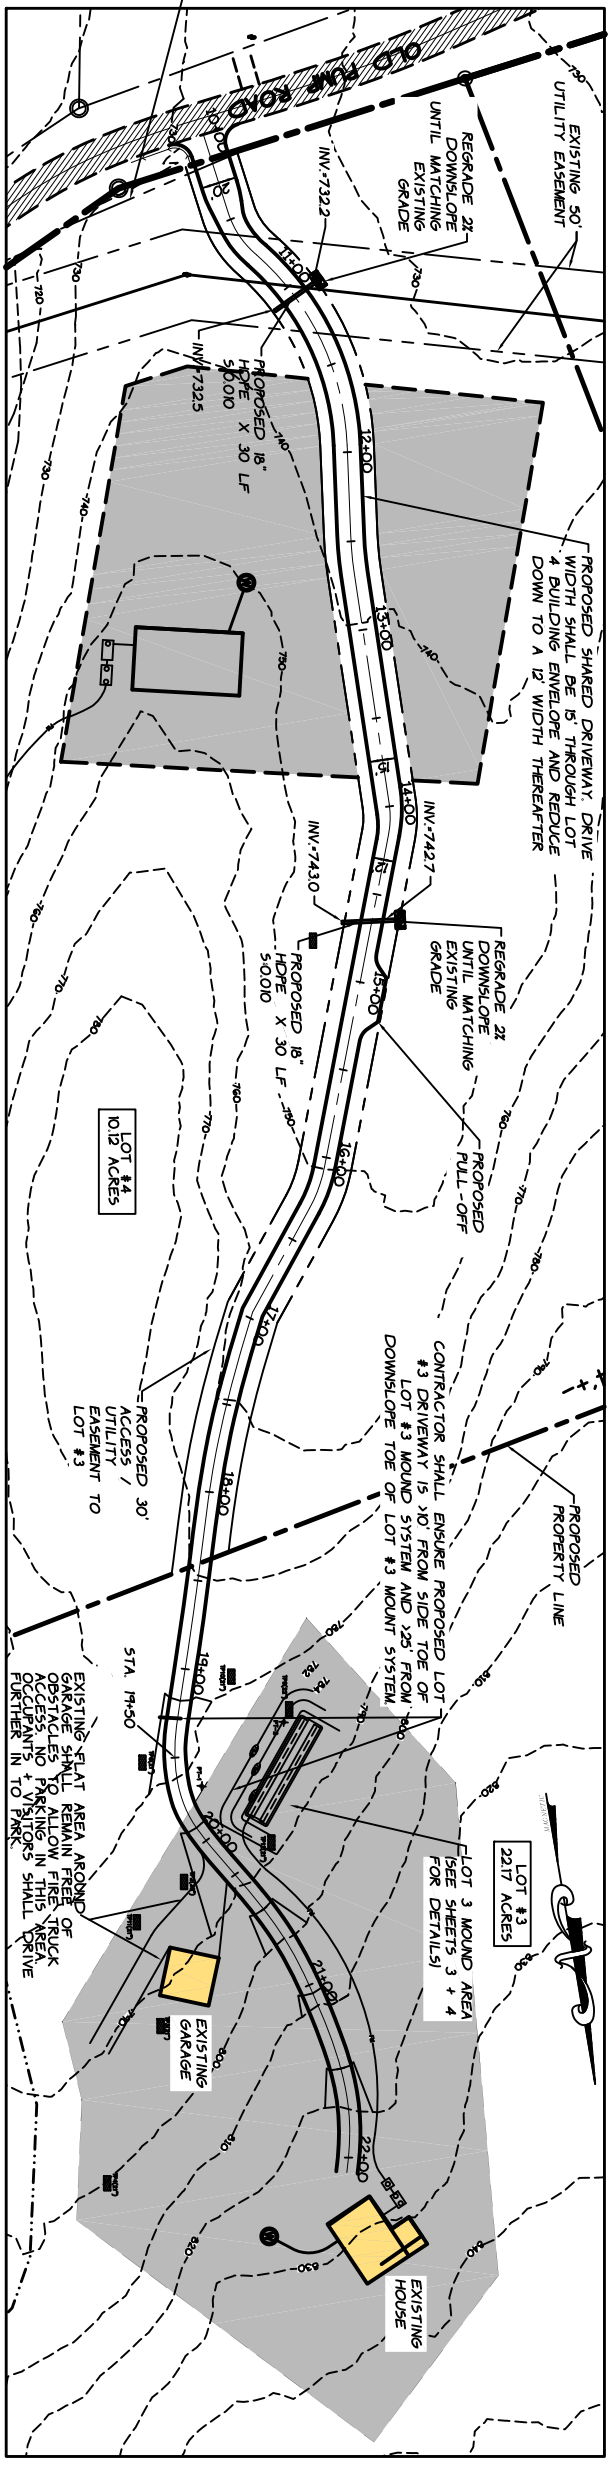


PROPOSED LOT 3 / 4 DRIVEWAY PLAN VIEW
HORIZONTAL SCALE: 1" = 50'

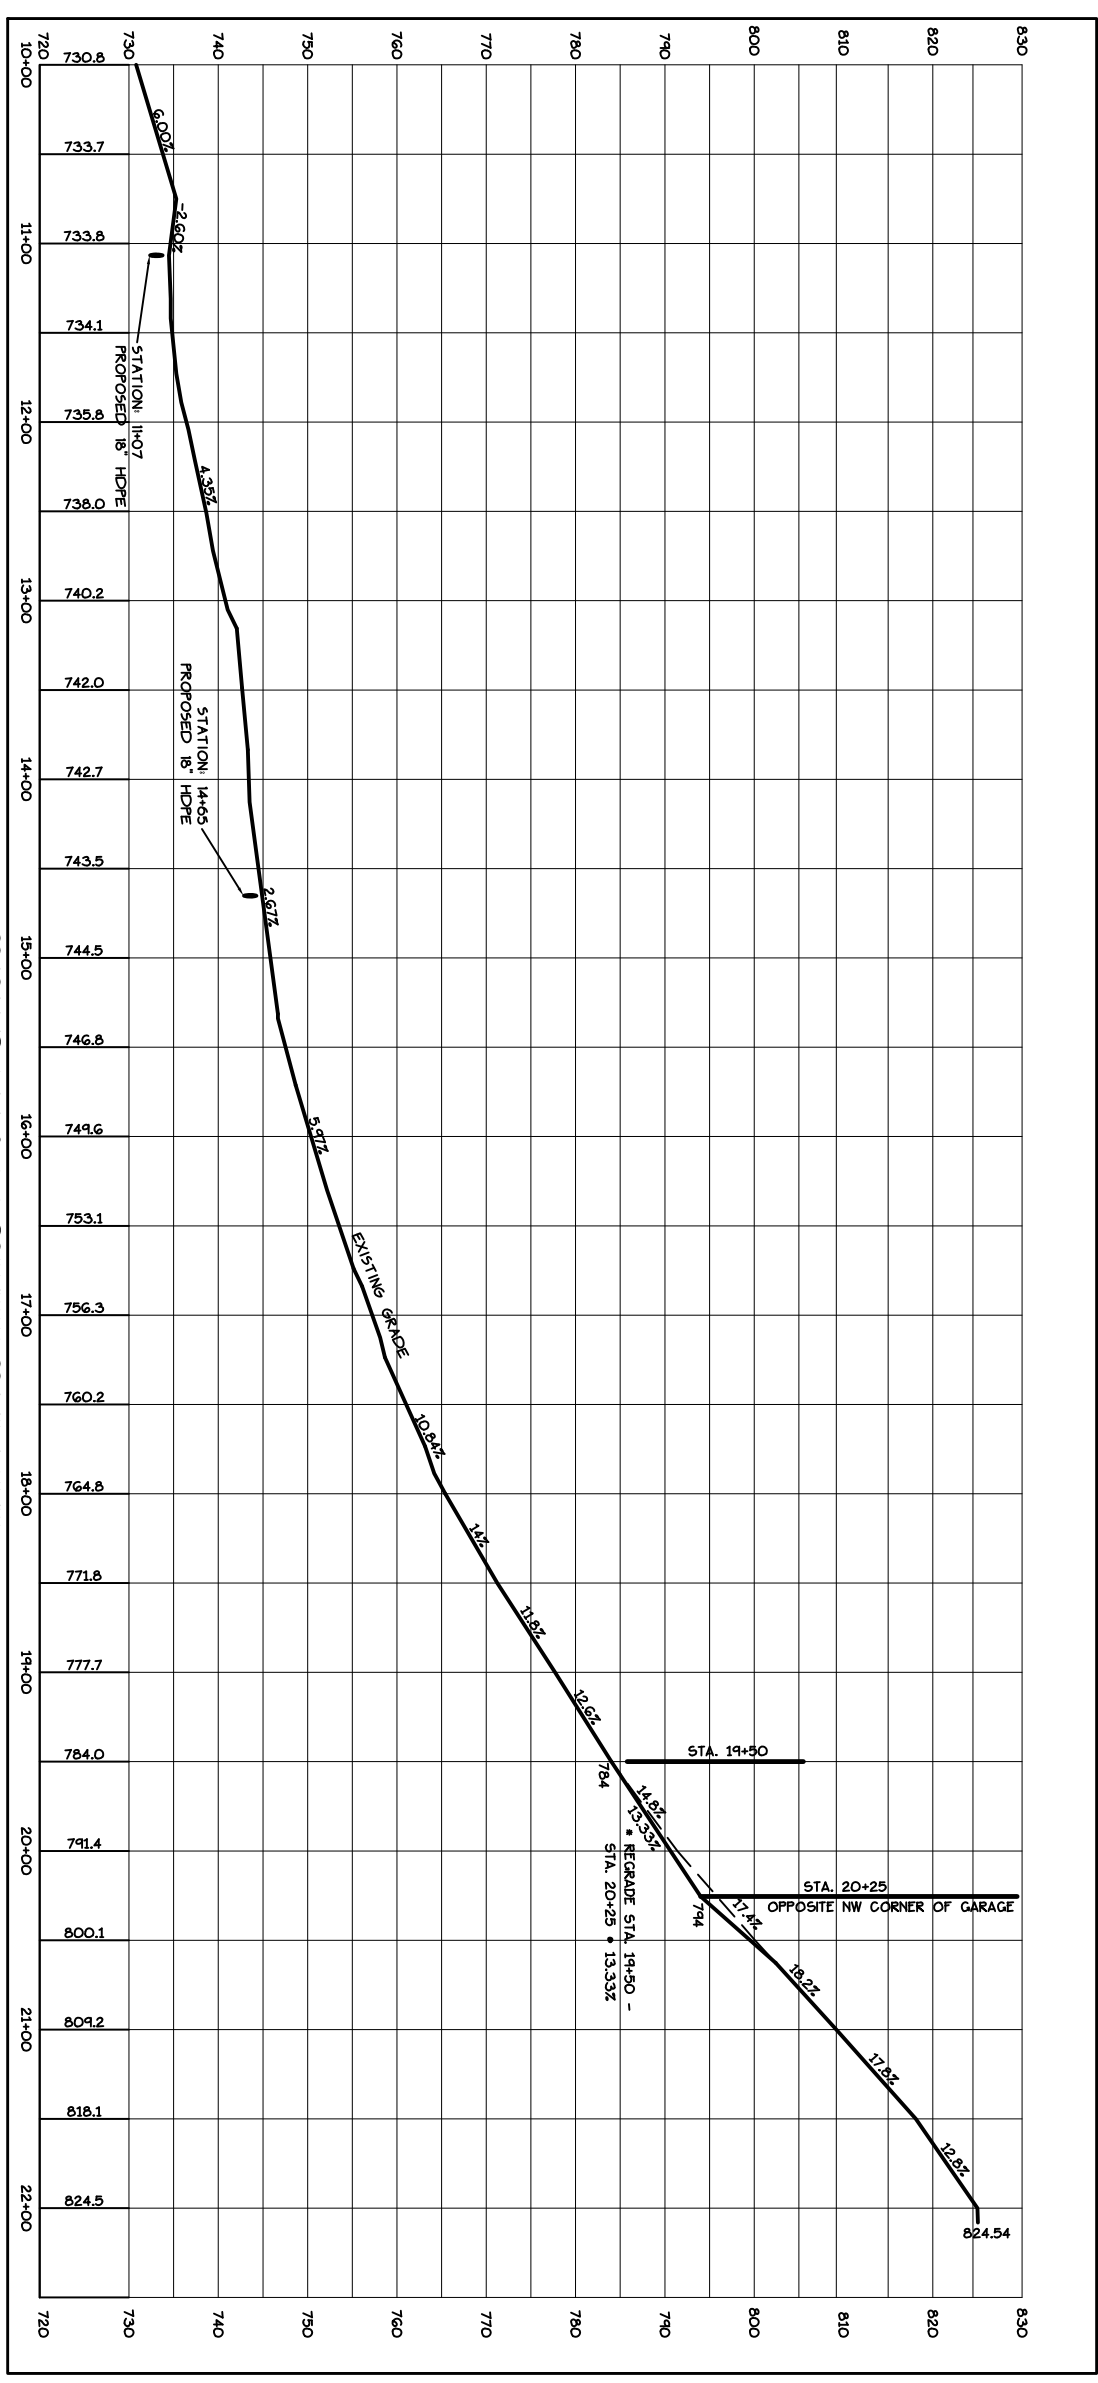

PROPOSED LOT 3 / 4 DRIVEWAY PROFILE VIEW
HORIZONTAL SCALE: 1" = 30'
VERTICAL SCALE: 1" = 10'

NOTE: REFER TO SLIDE 5076 FOR SUBDIVISION PLAN.

THE CONTRACTOR SHALL NOTIFY TOWNSHIPS AT 1-888-910-SAFE PRIOR TO ANY EXCAVATION.

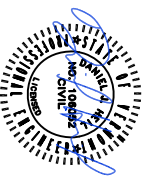

DATE: 07/11	REVISION: REVISED THE ROAD 11 x 14 DRIVE TO REMAIN, REMOVING TOTAL WIDENING ACCESS, 1 x ACROSS SLICE REFERENCE	BY: CMB
DATE: 07/11	REVISION: ADDED NOTES REGARDING SET OF DRIVEWAY, REMOVING OF TRAIL / PARKING PORTION	BY: CMB
DATE: 07/11	REVISION: RECORD DRAWING	BY: CMB
DATE: 07/11	REVISION: FINAL	BY: CMB
DATE: 07/11	REVISION: PRELIMINARY	BY: CMB
DATE: 07/11	REVISION: SCHEDULE/COMMENT	BY: CMB
DATE: 07/11	REVISION: CIVIL ASSOCIATES, P.C.	BY: CMB
DATE: 07/11	REVISION: DRAWINGS	BY: CMB
DATE: 07/11	REVISION: DIMS	BY: CMB
DATE: 07/11	REVISION: SCALE	BY: CMB
DATE: 07/11	REVISION: H: 1'-0"	BY: CMB
DATE: 07/11	REVISION: V: 1'-0"	BY: CMB

13 CONVENT DRIVE
SOUTH VERMONT, VERMONT 05488
PHONE: 879-8800
FAX: 879-8800
EMAIL: OBA@OLEARYBURKE.COM

O'LEARY-BURKE CIVIL ASSOCIATES, P.C.
12 OLD PLUM ROAD
5595X, VT
2015-28-55
PLAN SHEET #

**MORSE WOODS
HIPES - LOT 3**

**DRIVEWAY
PLAN + PROFILE**

2A